

FORM FA7

**OFFICE USE ONLY
REGISTER NO**

SHROPSHIRE COUNTY COUNCIL

WILDLIFE AND COUNTRYSIDE ACT 1981

DEFINITIVE MAP OF RIGHTS OF WAY FOR SHROPSHIRE

APPLICATION FOR MODIFICATION ORDER

To: The Principal Rights of Way Officer
The Countryside Service
Shropshire County Council
The Shirehall
Abbey Foregate
SY2 6ND

~~¶~~We as Councillors
of CHURCH PREEN, HUGHLEY & KENLEY PARISHS

hereby apply for an Order under Section 53 (2) of the Wildlife and Countryside Act 1981,
modifying the Definitive Map and Statement for the area by deleting the following right of
way:-

A footpath/~~bridleway/byway open to all traffic*~~
from wrongly marked as Footpath N°2
to in the parish of Kenley

as shown on the map accompanying this application.

~~¶~~We attach copies of the following documentary evidence, including statements of witnesses,
in support of this application. Form FAB has been served on Mr & Mrs K Lee


Dated 9th March 2000
Signed K.M. Roycroft (Parish Clerk)

*delete as appropriate

SHROPSHIRE COUNTY COUNCIL
 WILDLIFE AND COUNTRYSIDE ACT 1981
 Formal Application to delete Footpath No 2 : Kenley

APPENDIX A

Map No: 1
 OS Sheet: SO 5599

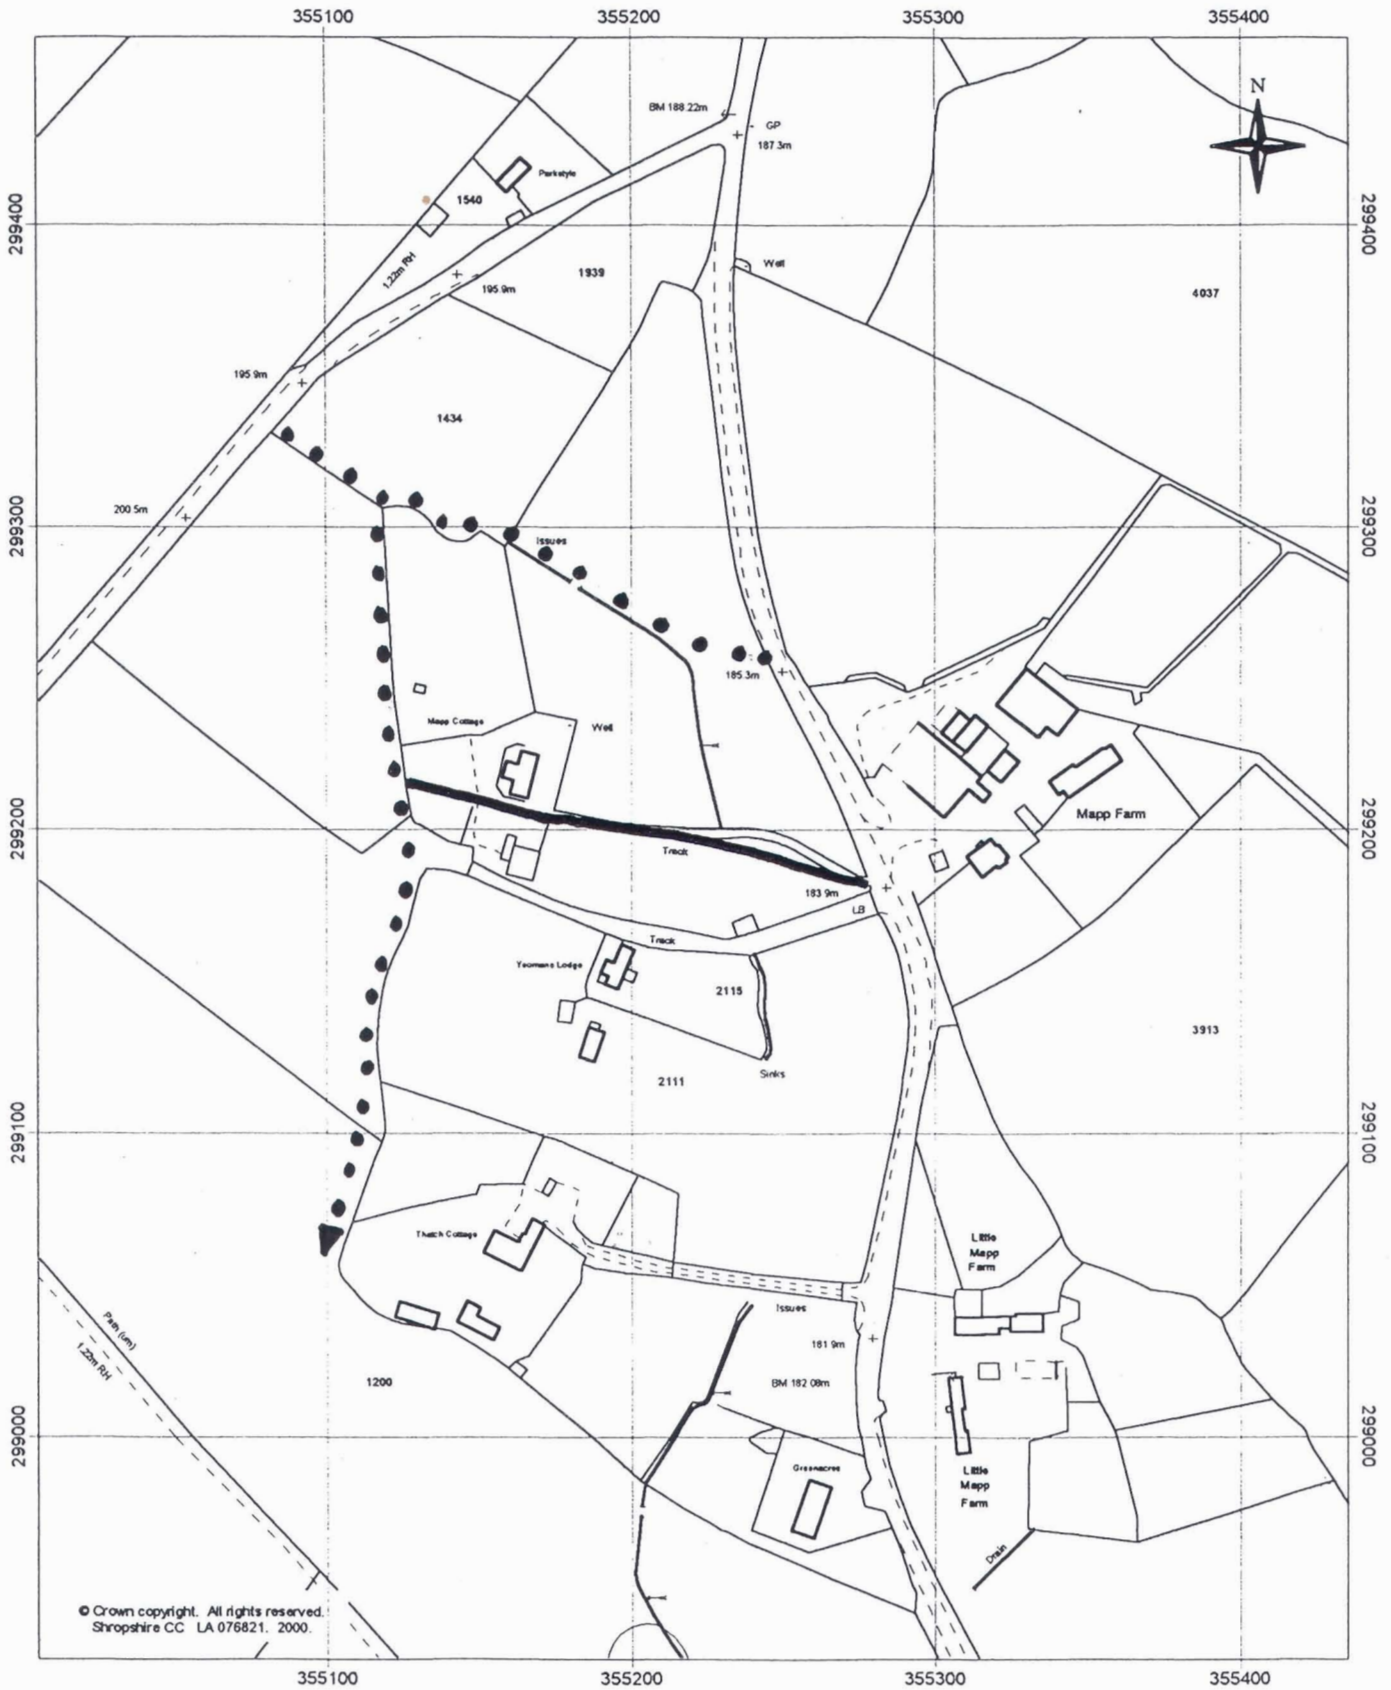

© Crown copyright. All rights reserved.
 Shropshire CC LA 076821. 2000.



The Shirehall, Abbey Foregate
 Shrewsbury, SY2 6ND

Key



Claimed deletion
 Existing to remain

Scale 1:2500